

OCCUPANCY OF SIUT OPD -14

Ground Floor:-

- Patient examine room
- Male/female waiting area'
- Ultrasound room
- Female Ultrasound room
- Meeting room
- Kitchen
- Blood Collection Area
- Main laundry

1st Floor


- Patient examine room
- Patient record room

New Wetting Area

- Ground floor New Wetting Area Male/Female
- Token Area
- 1st floor New Wetting Area Male/Female

Roof

- Patient record room

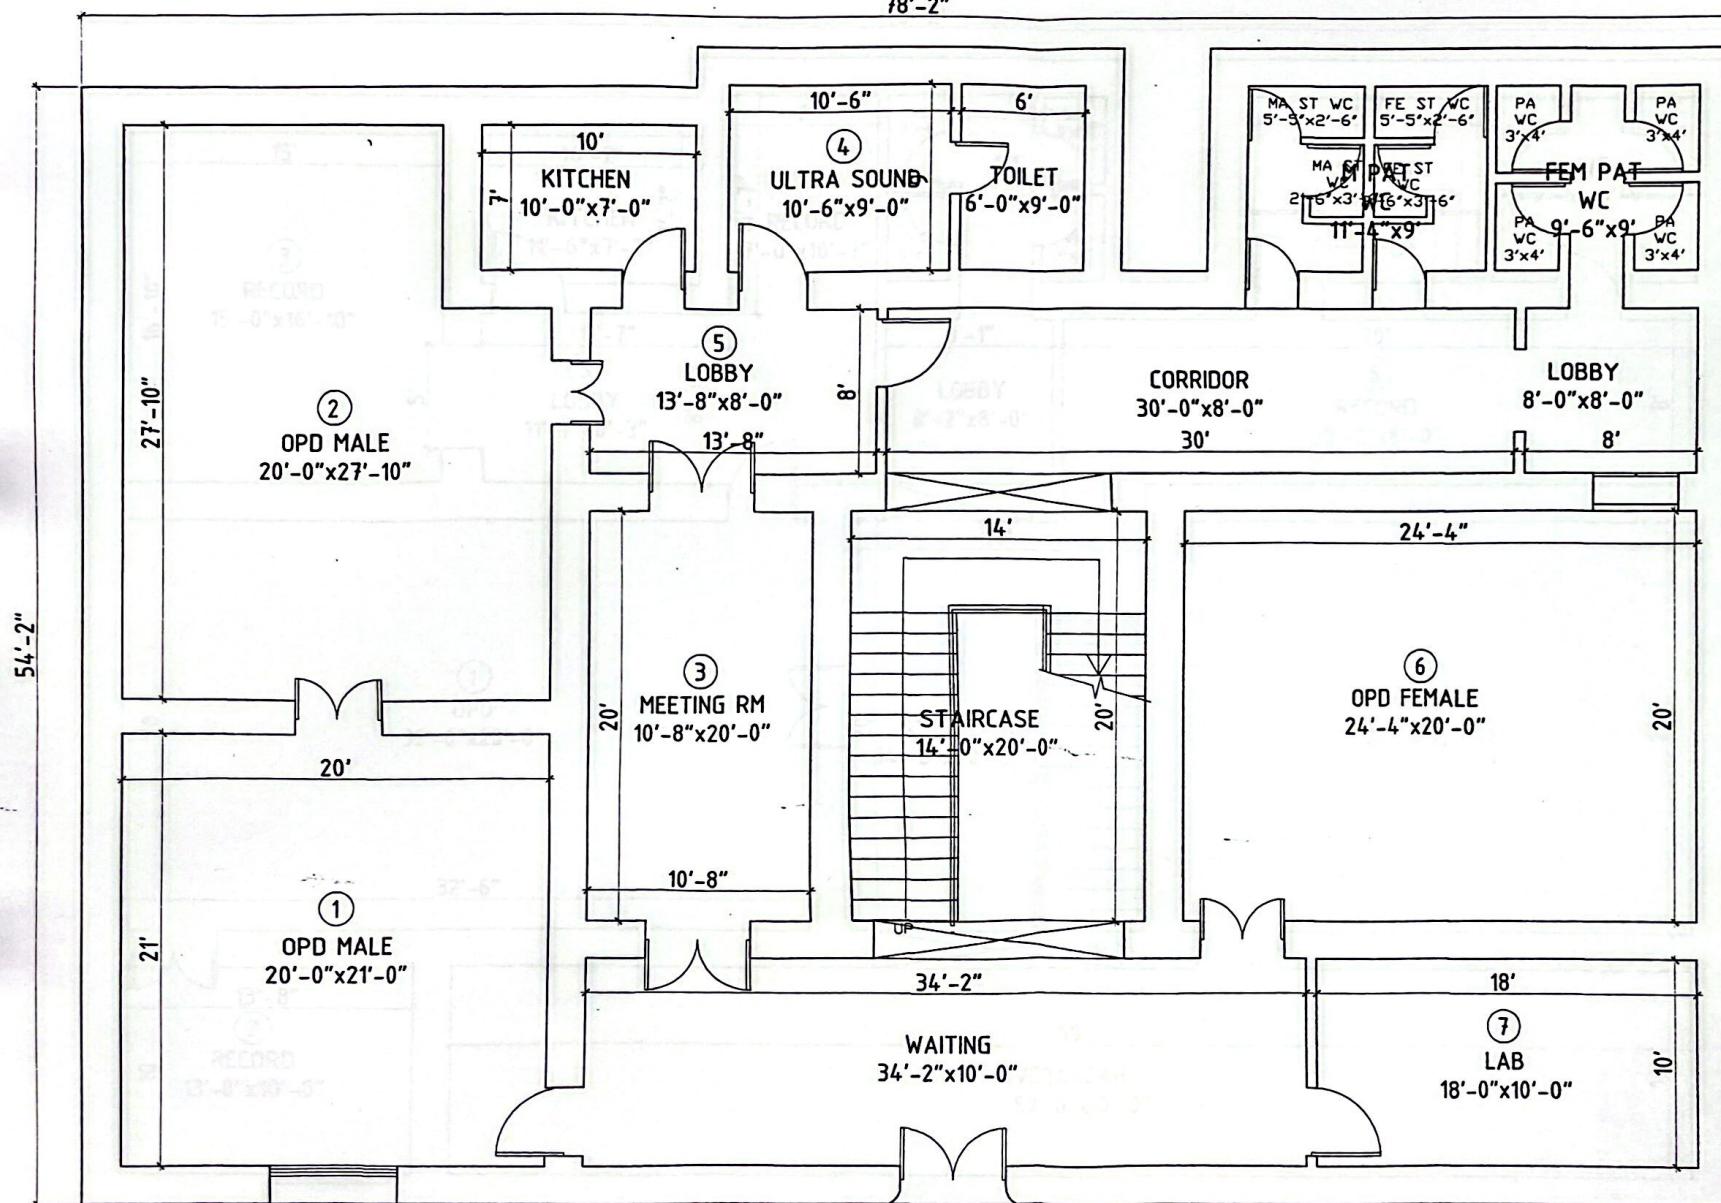

SIUT OPD 14 CIVIL HOSPITAL

GROUND FLOOR PLAN


DRAWN: SYED RAZA ABBAS		CHECKED BY: _____	DATE: _____
TITLE: AS BUILT DRAWING			

SIUT OPD 14 CIVIL HOSPITAL

FIRST FLOOR PLAN

JOB NO.

DWG NO.

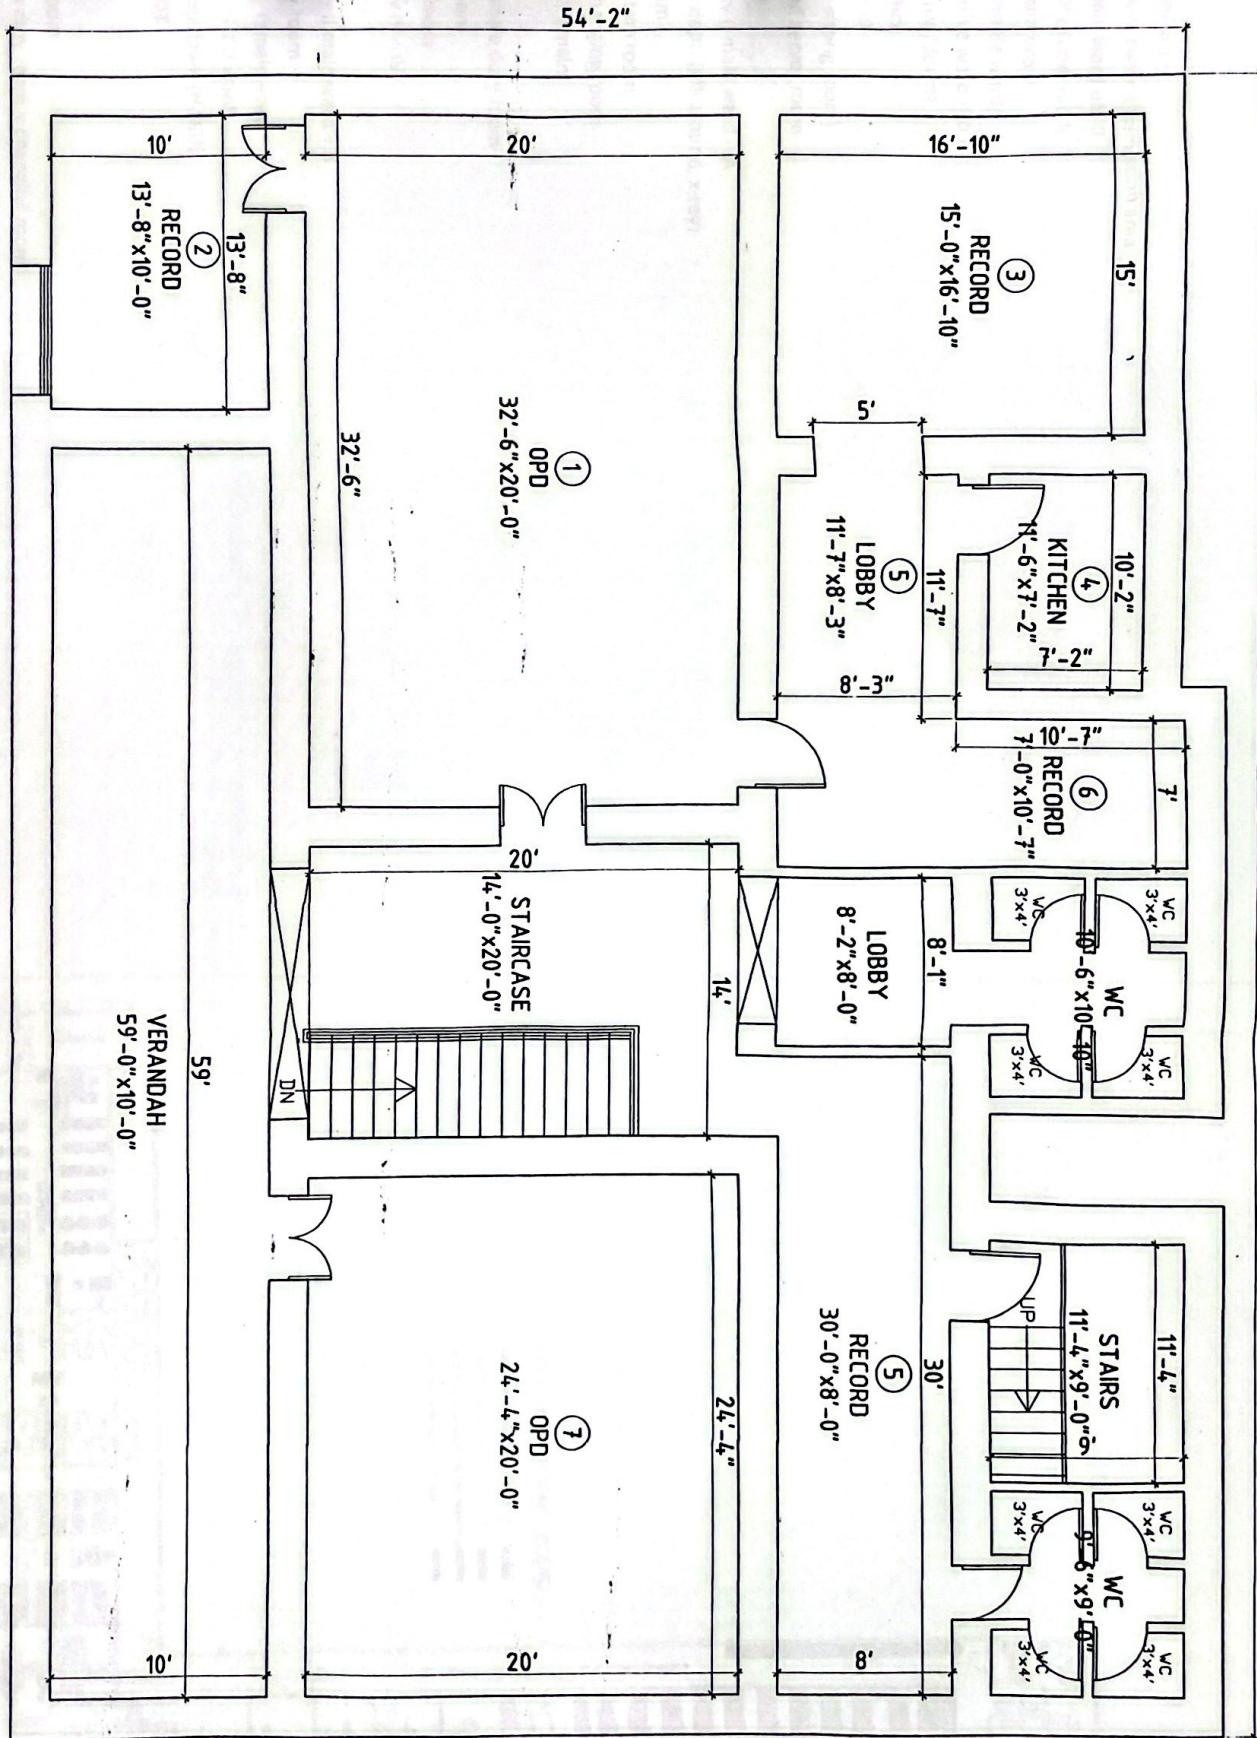

DRAWN: SYED RAZA ABBAS | CHECKED BY: | DATE: |

TITLE: AS BUILT DRAWING